



AS-BUILT EXAMPLES
NO TO SCALE

NO. ISSUE/REVISION DATE

PROJECT

SCALE

DRAWN BY

DATE

DRAWING NO.
ELEVATIONS



AS-BUILT EXAMPLES
NO TO SCALE

NO. ISSUE/REVISION DATE



PROJECT _____

SCALE _____

DRAWN BY _____

DATE _____

DRAWING NO.
ELEVATIONS

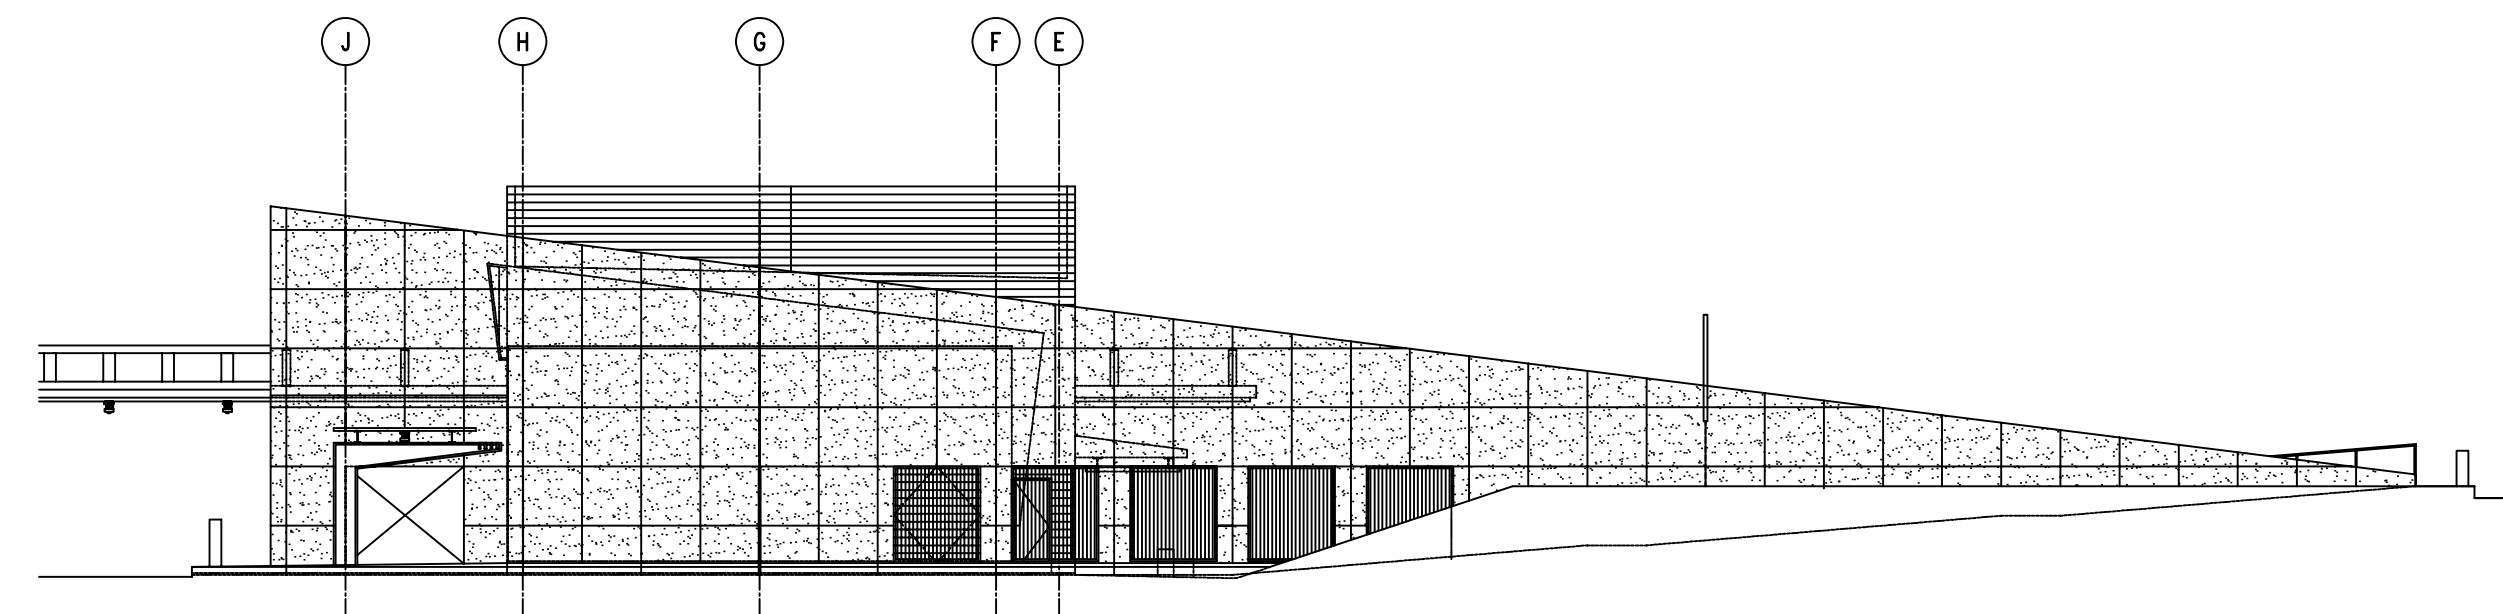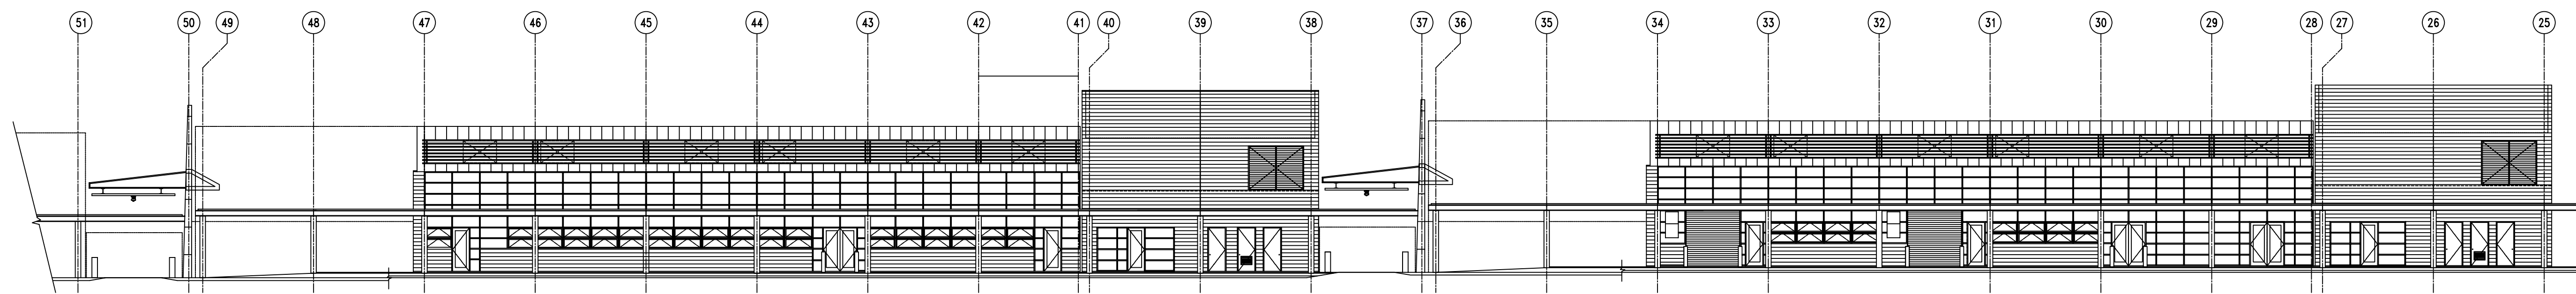

AS-BUILT EXAMPLES
NO TO SCALE

NO. ISSUE/REVISION DATE


PROJECT _____

SCALE _____

DRAWN BY _____


DATE _____

DRAWING NO.
ELEVATIONS

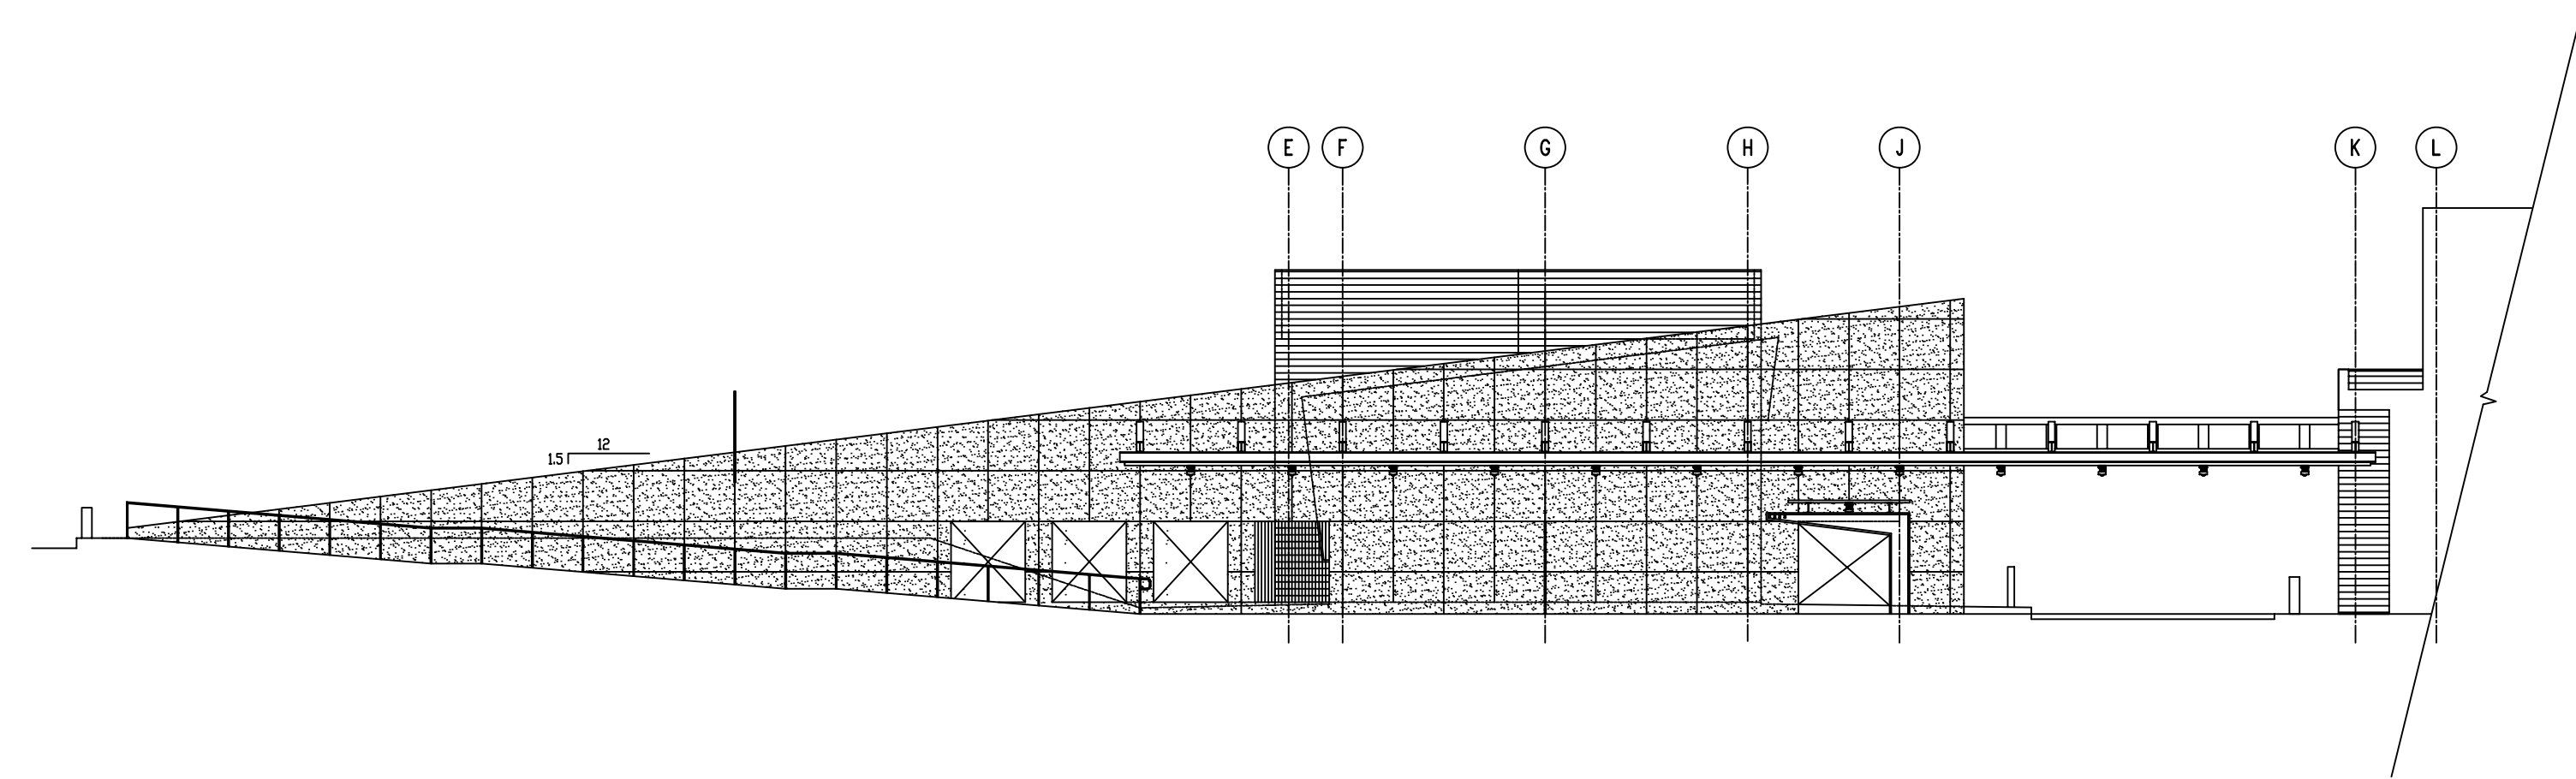

AS-BUILT EXAMPLES
NO TO SCALE

NO. ISSUE/REVISION DATE

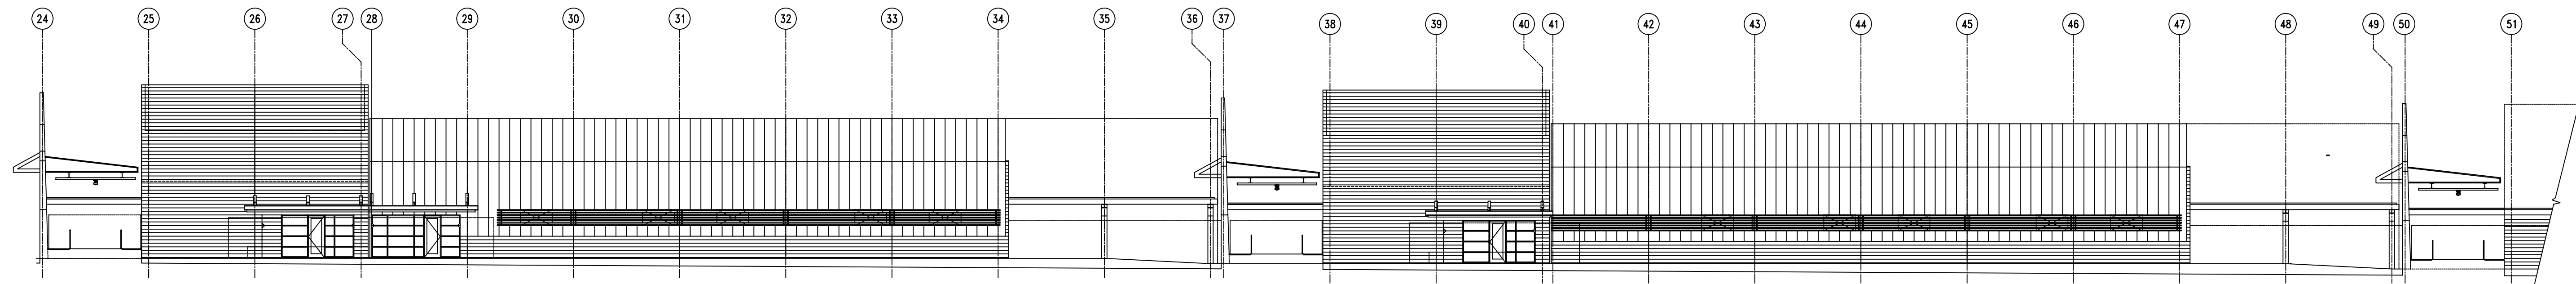

PROJECT _____

SCALE _____

DRAWN BY _____

DATE _____

DRAWING NO.
ELEVATIONS



AS-BUILT EXAMPLES
NO TO SCALE

NO. ISSUE/REVISION DATE



PROJECT _____

SCALE _____

DRAWN BY _____

DATE _____

DRAWING NO.
ELEVATIONS

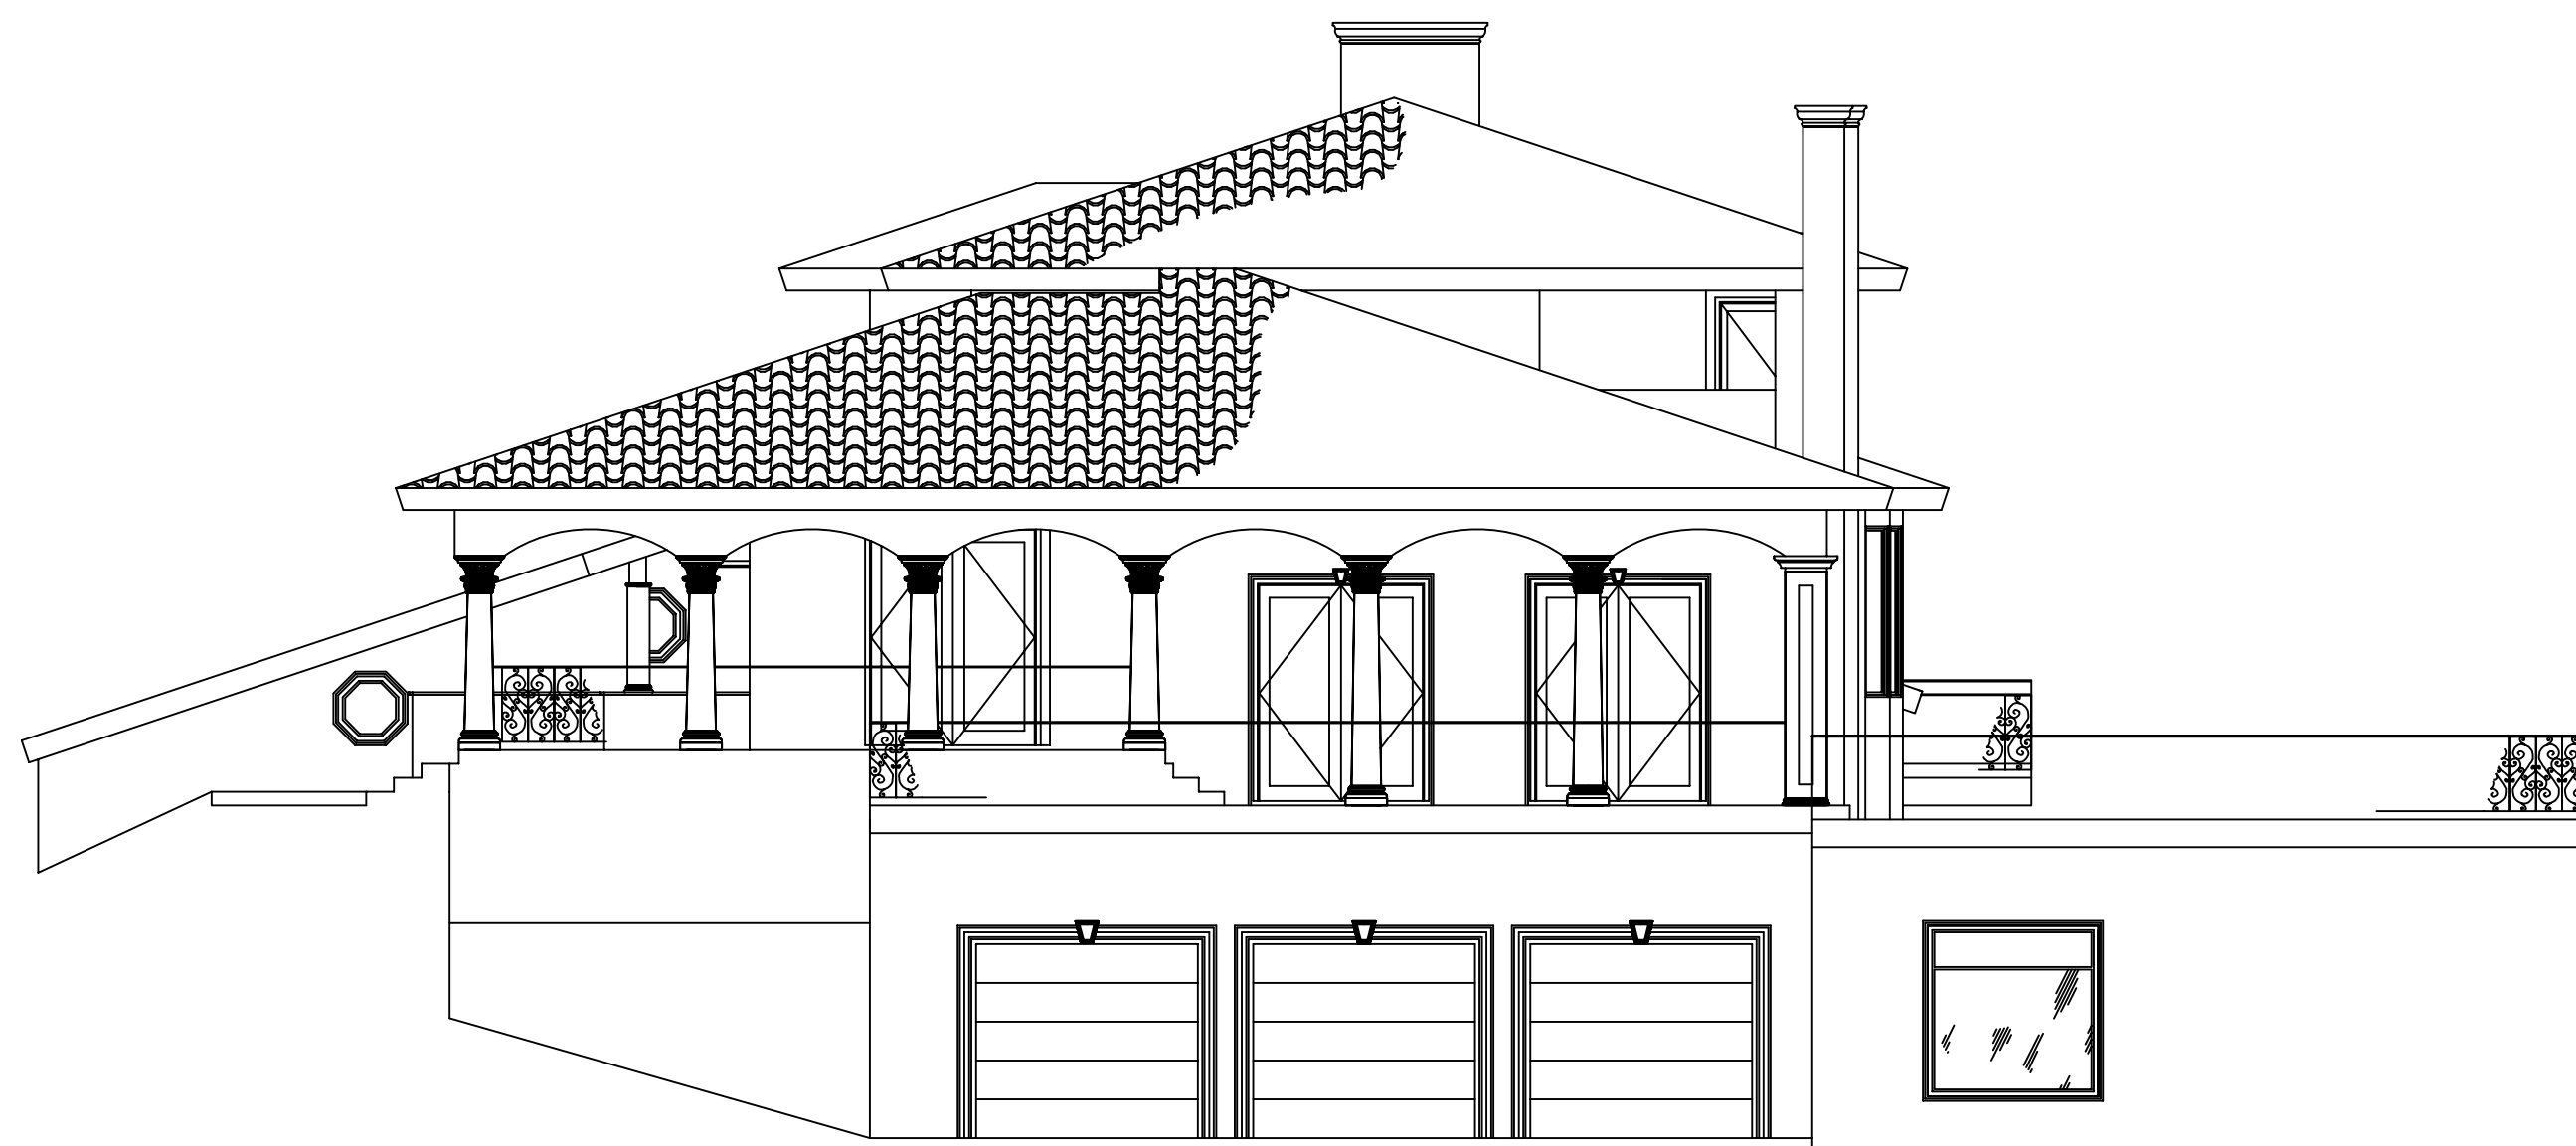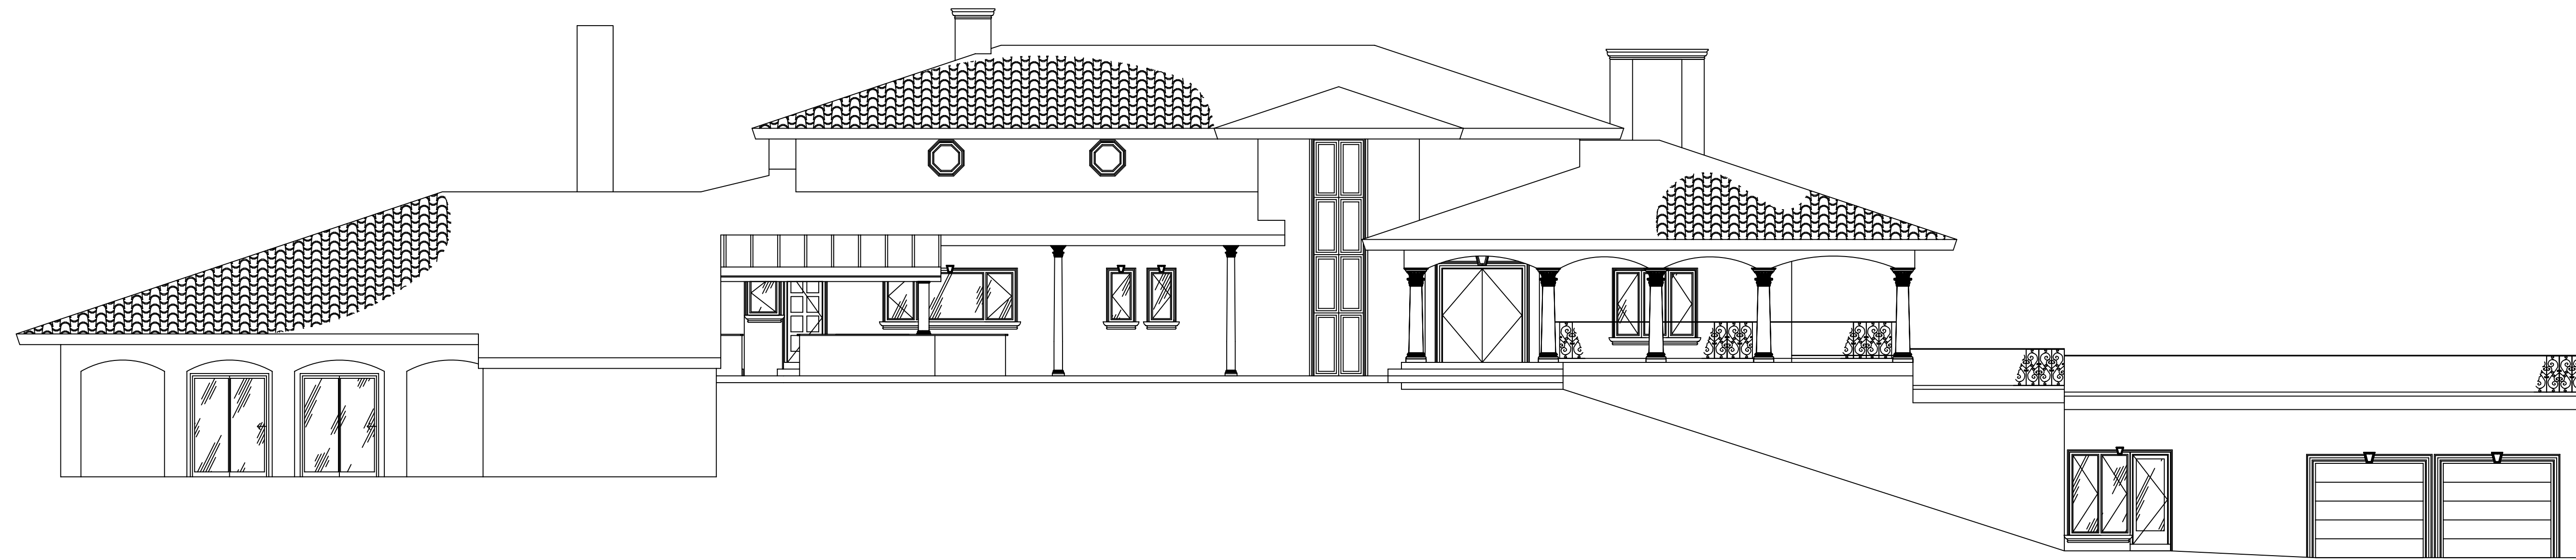

AS-BUILT EXAMPLES
NO TO SCALE

NO. ISSUE/REVISION DATE


PROJECT _____

SCALE _____

DRAWN BY _____


DATE _____

DRAWING NO.
ELEVATIONS

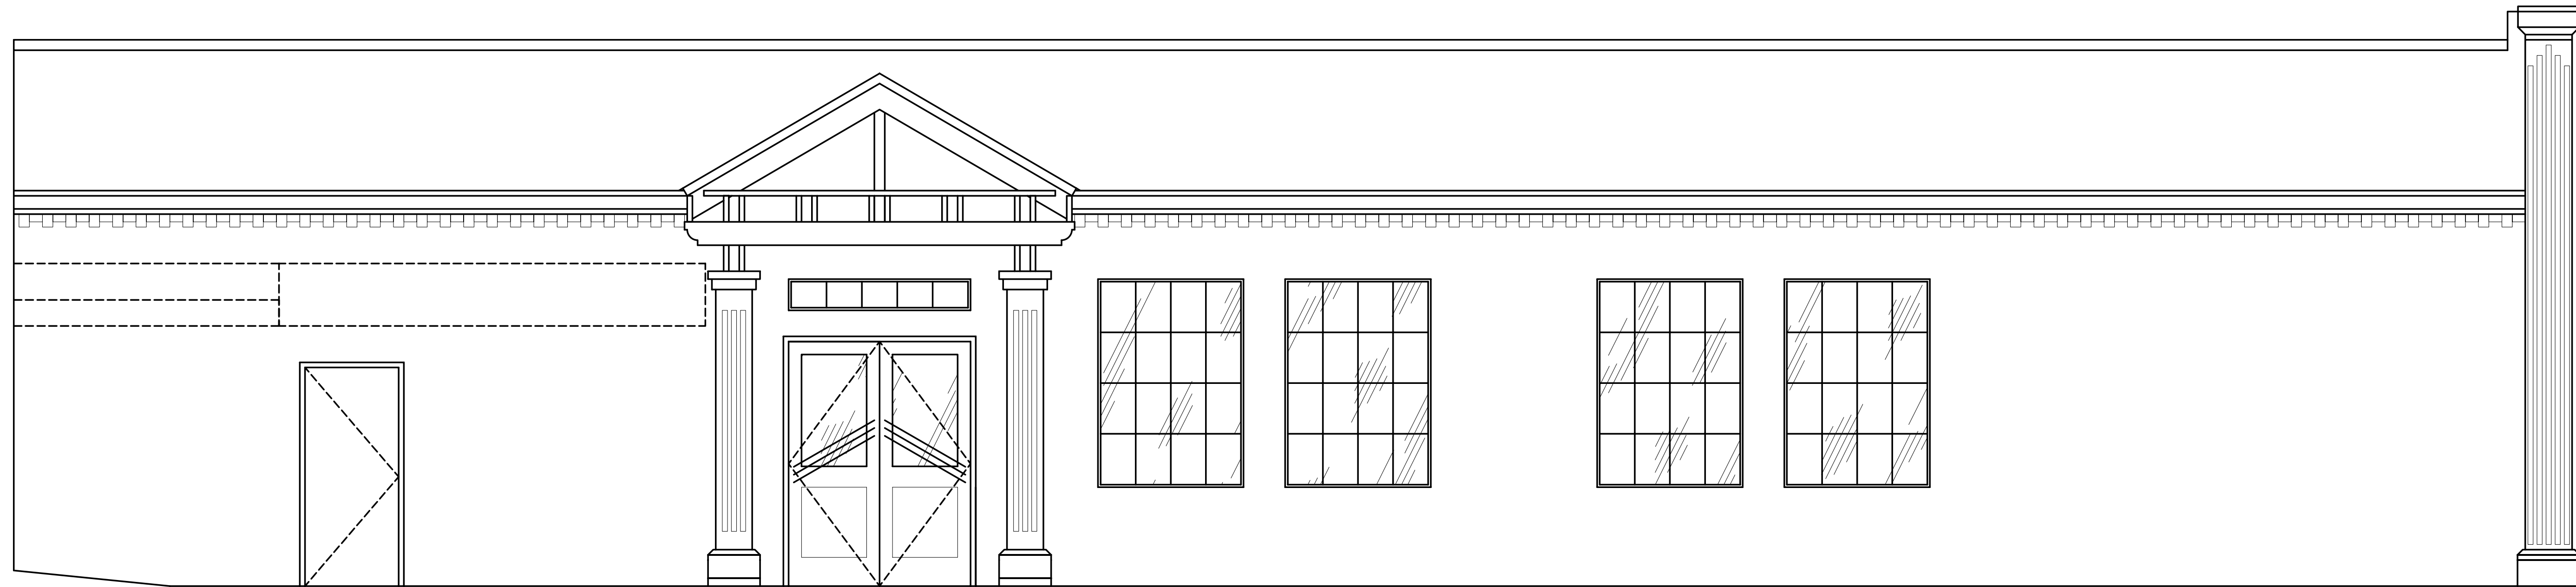

AS-BUILT EXAMPLES
NO TO SCALE

NO. ISSUE/REVISION DATE

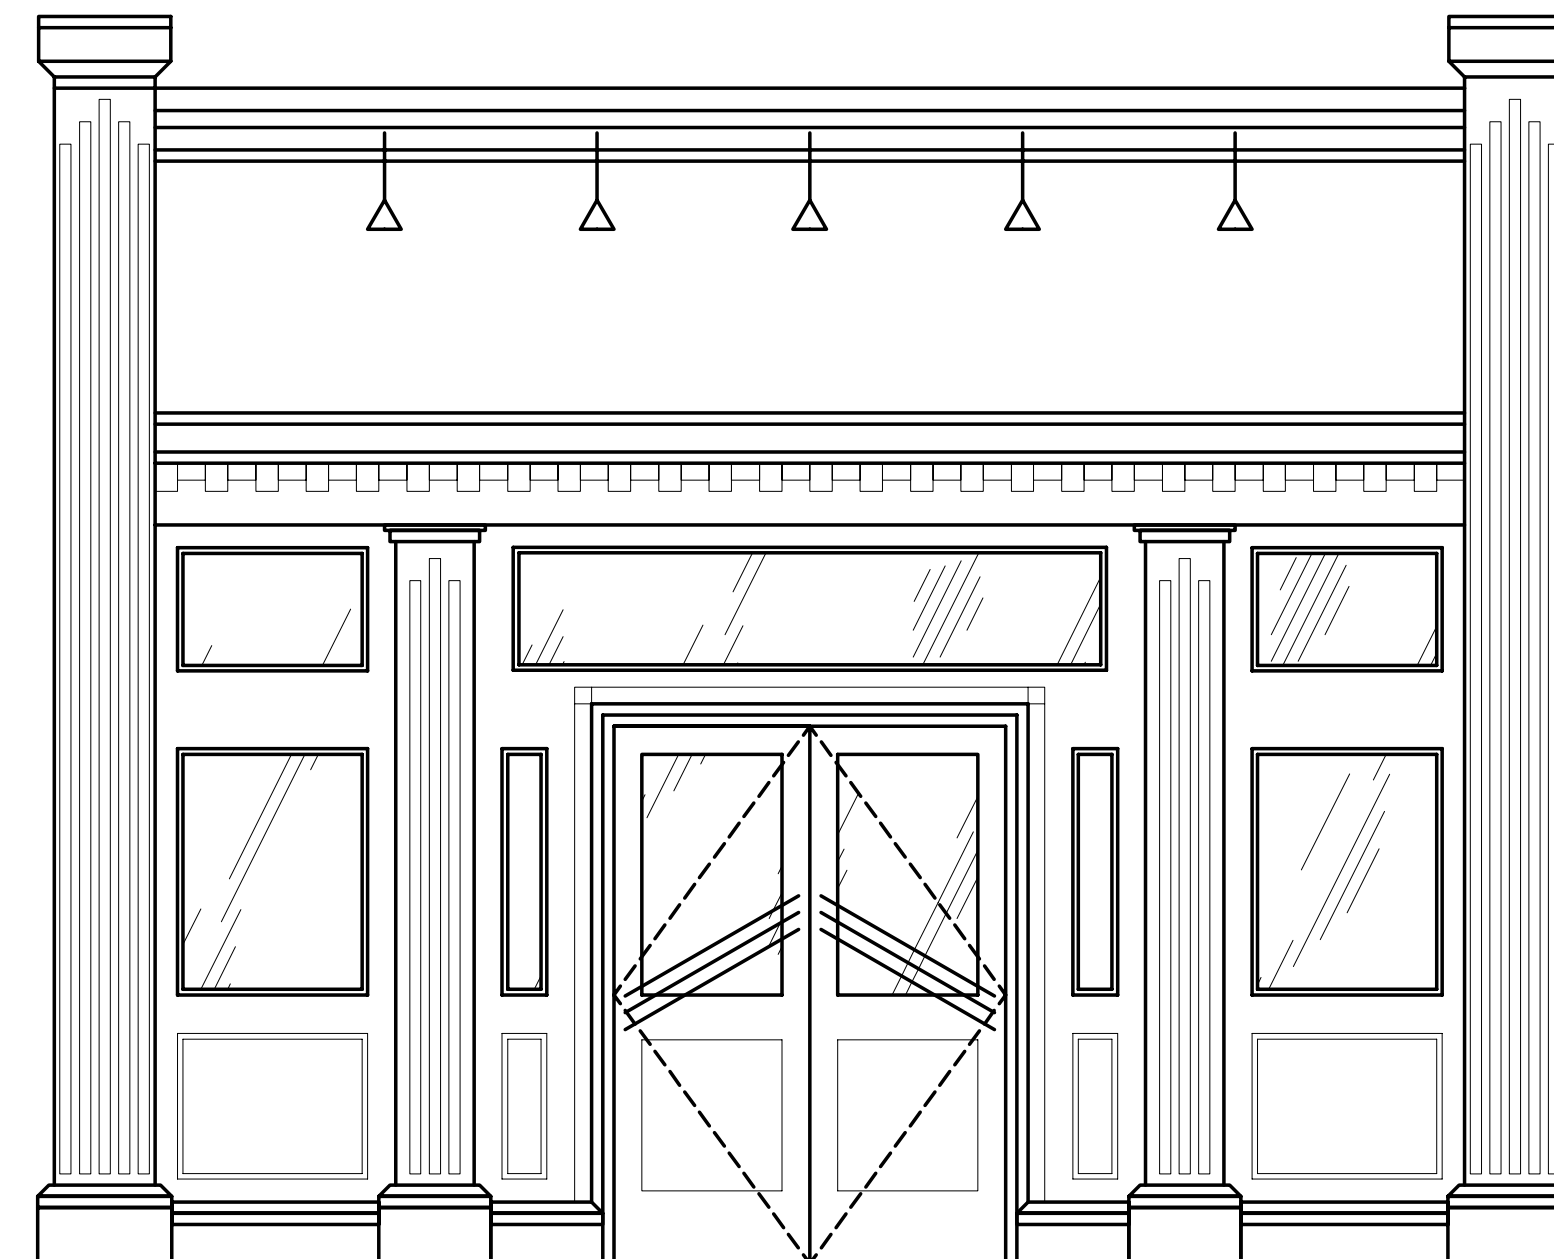


PROJECT _____

SCALE _____

DRAWN BY _____


DATE _____

DRAWING NO.
ELEVATIONS

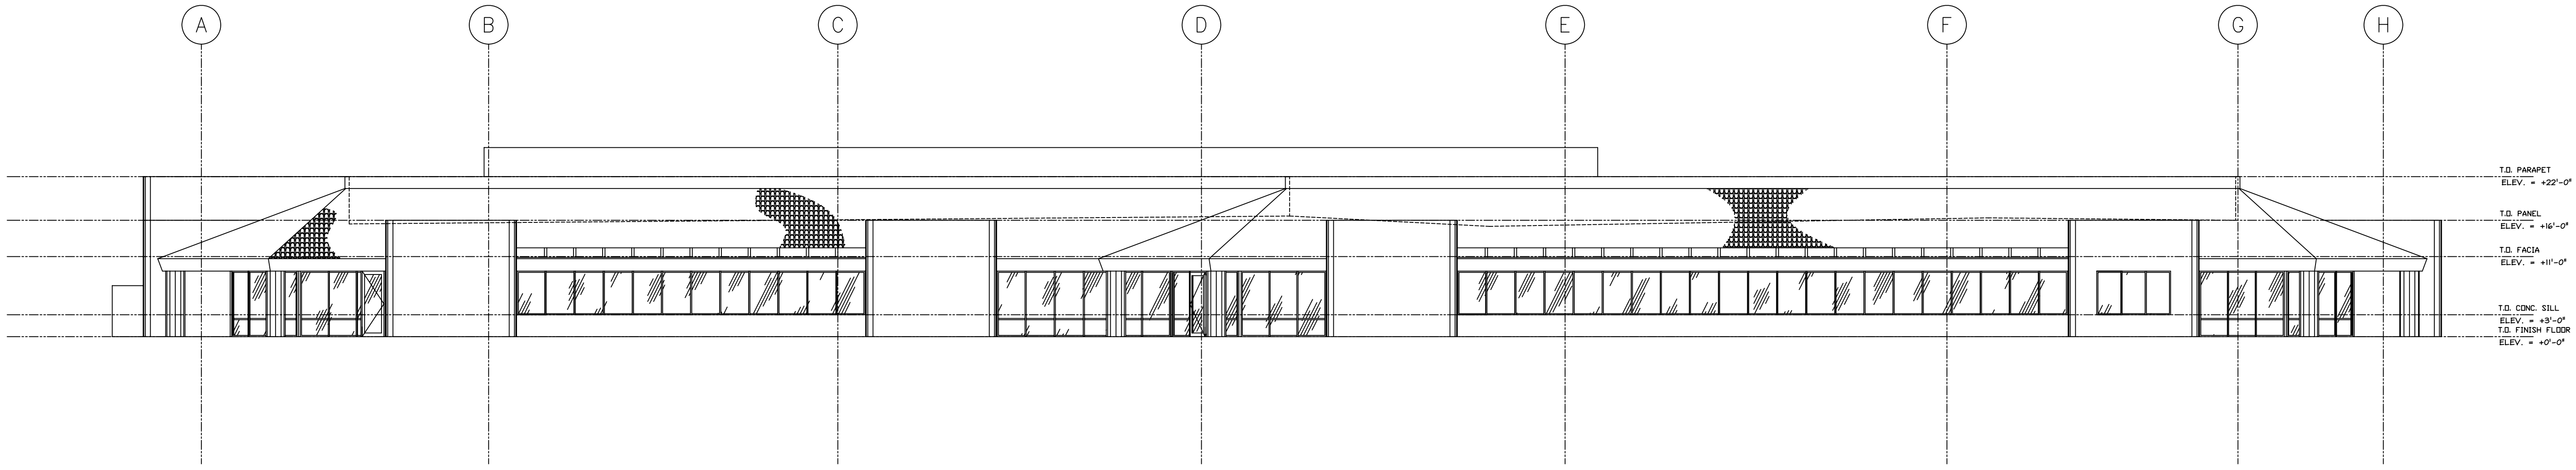

AS-BUILT EXAMPLES
NO TO SCALE

NO. ISSUE/REVISION DATE

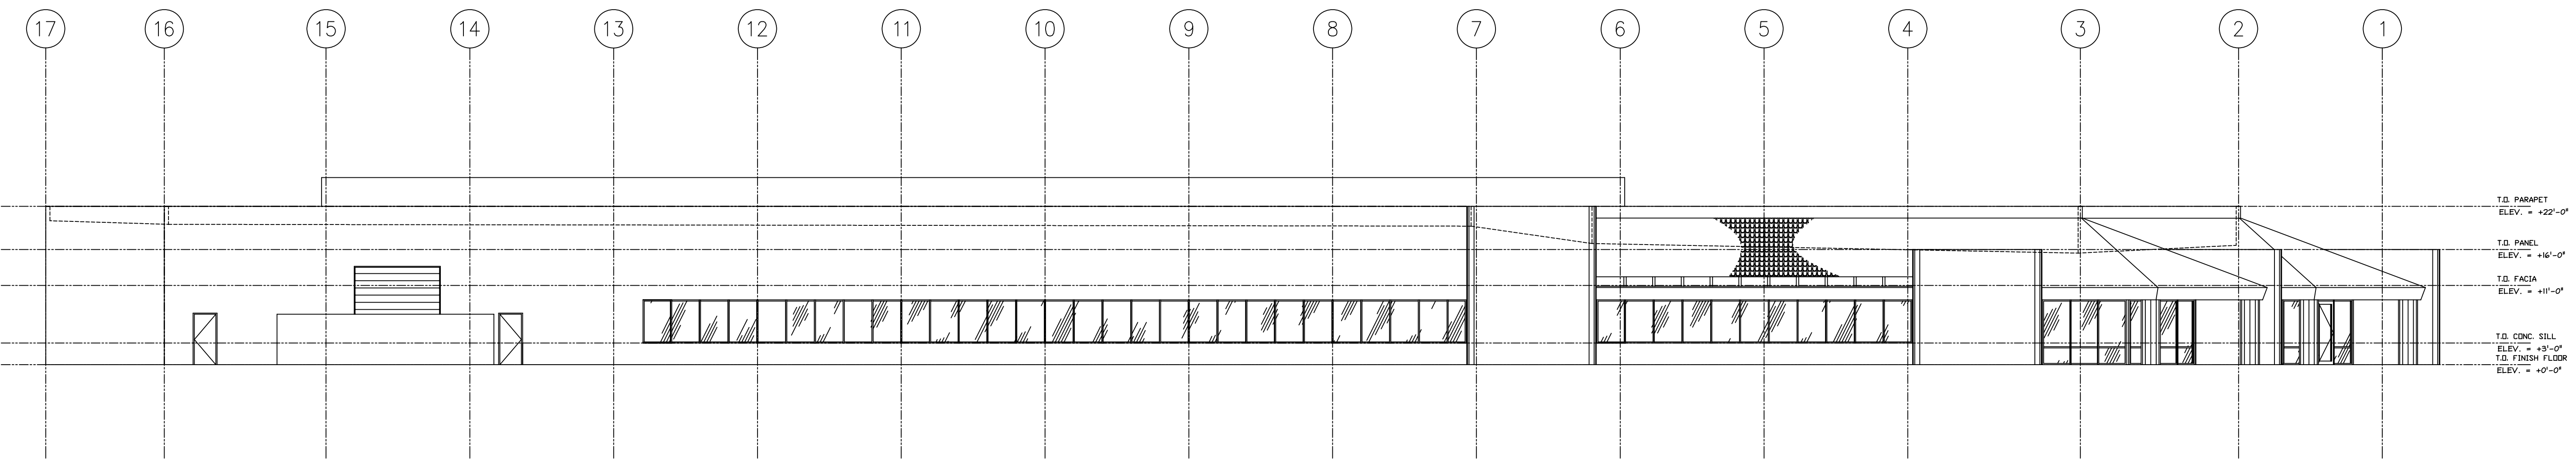

PROJECT _____

SCALE _____

DRAWN BY _____

DATE _____

DRAWING NO.
ELEVATIONS