

AS-BUILT EXAMPLES

NOT TO SCALE

NO.	ISSUE/REVISION	DATE


PROJECT _____

SCALE _____

DRAWN BY _____

DATE _____

DRAWING NO.
RESIDENTIAL

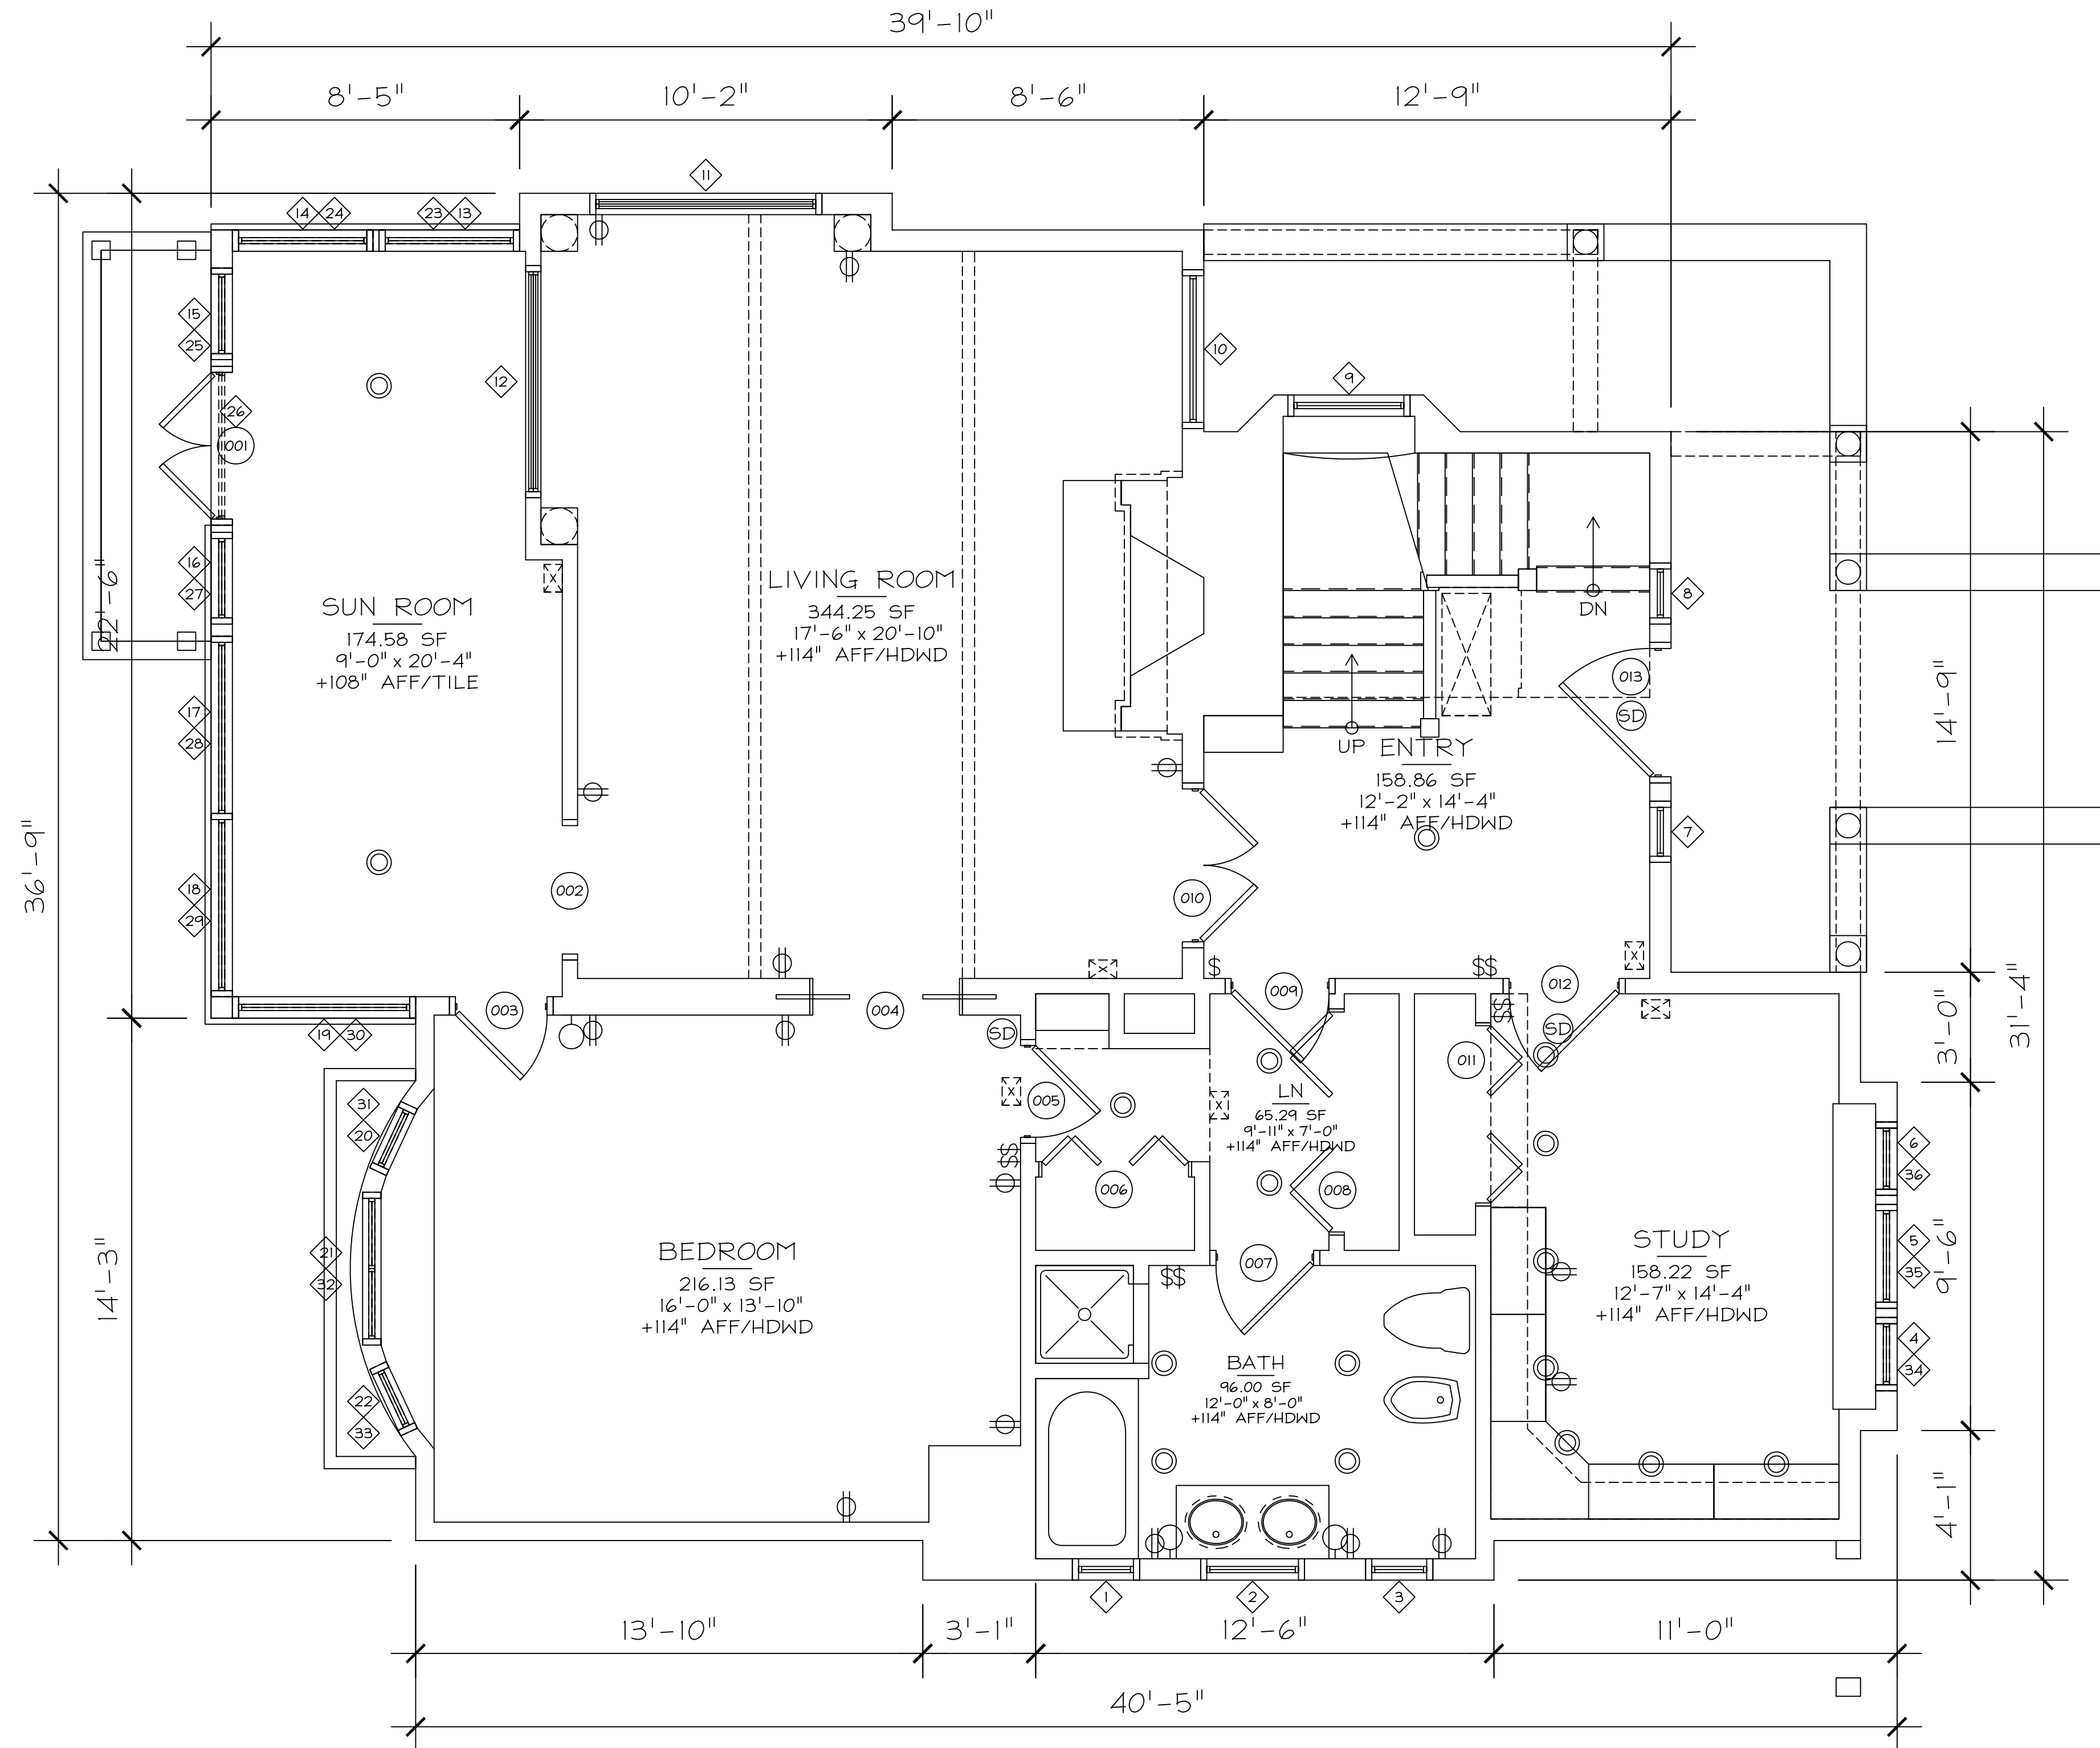

AS-BUILT EXAMPLES

NOT TO SCALE

NO.	ISSUE/REVISION	DATE


PROJECT _____

SCALE _____

DRAWN BY _____

DATE _____

DRAWING NO. **RESIDENTIAL**

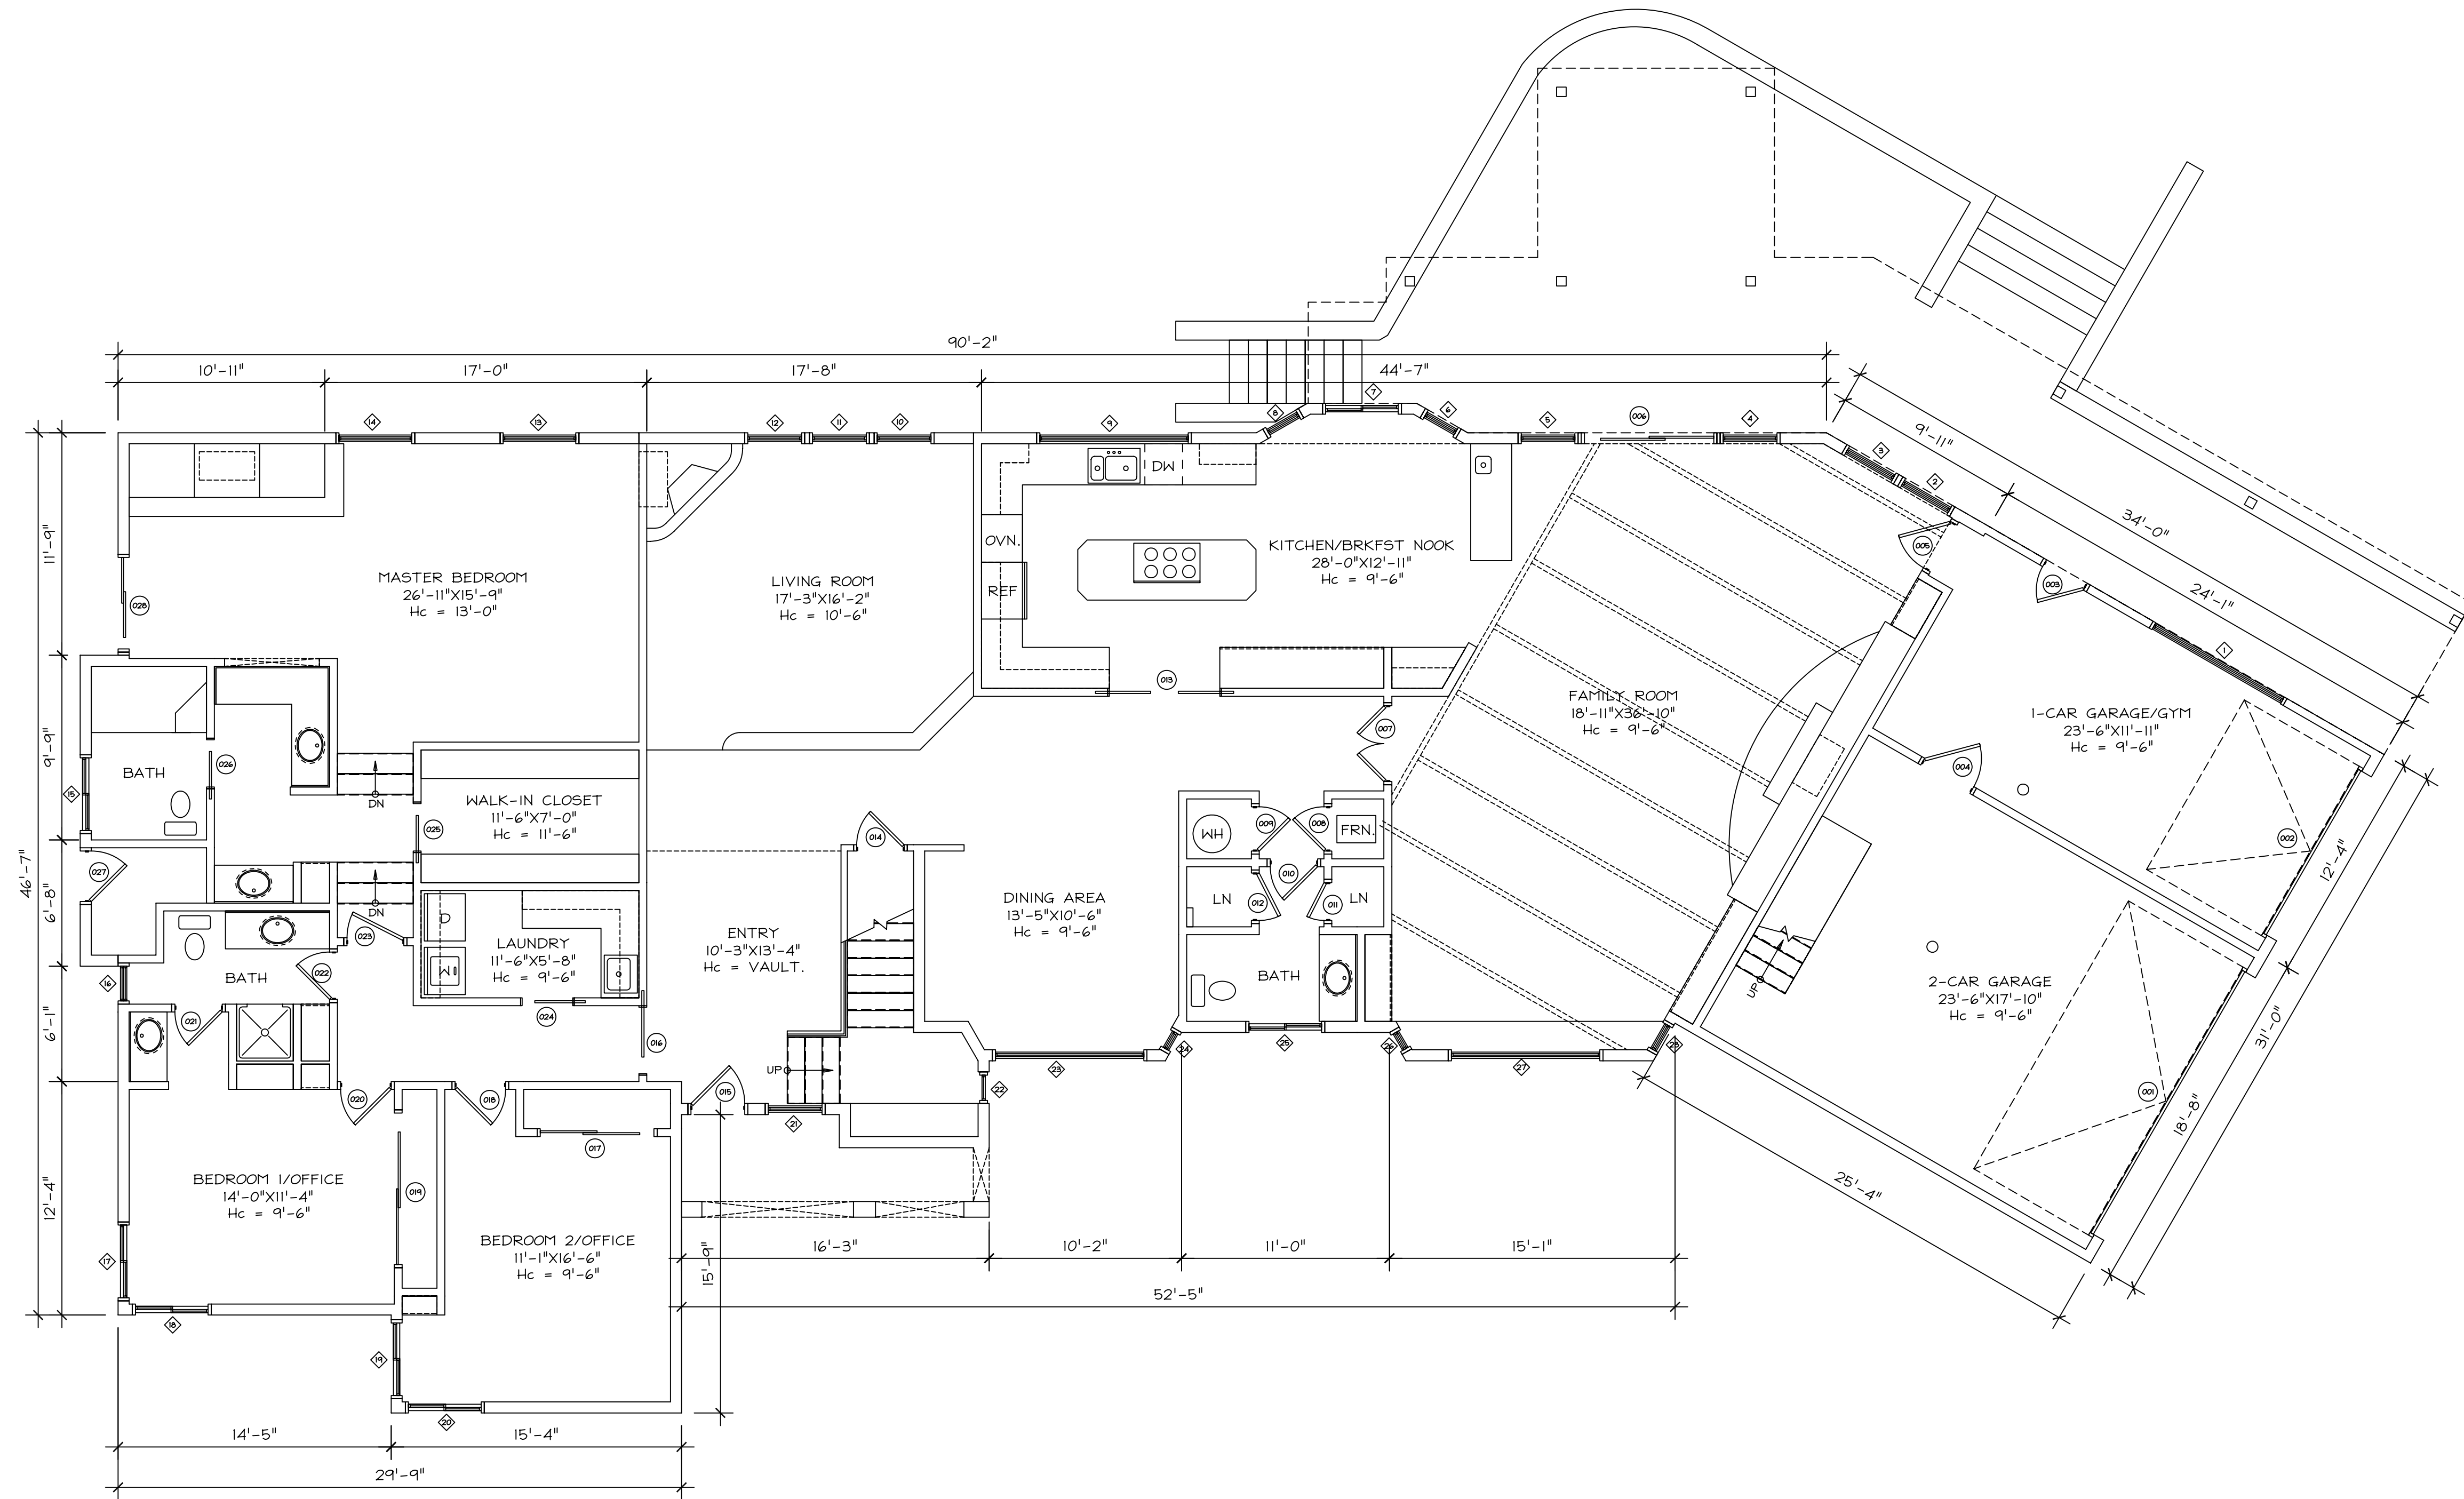

AS-BUILT EXAMPLES

NOT TO SCALE

NO.	ISSUE/REVISION	DATE

PROJECT _____

SCALE _____

DRAWN BY _____

DATE _____

DRAWING NO.
RESIDENTIAL